


1 TYPICAL ELEVATOR LOBBY ELEVATIONS  
AS.11.43 1/4"=1'-0"

AE004-8

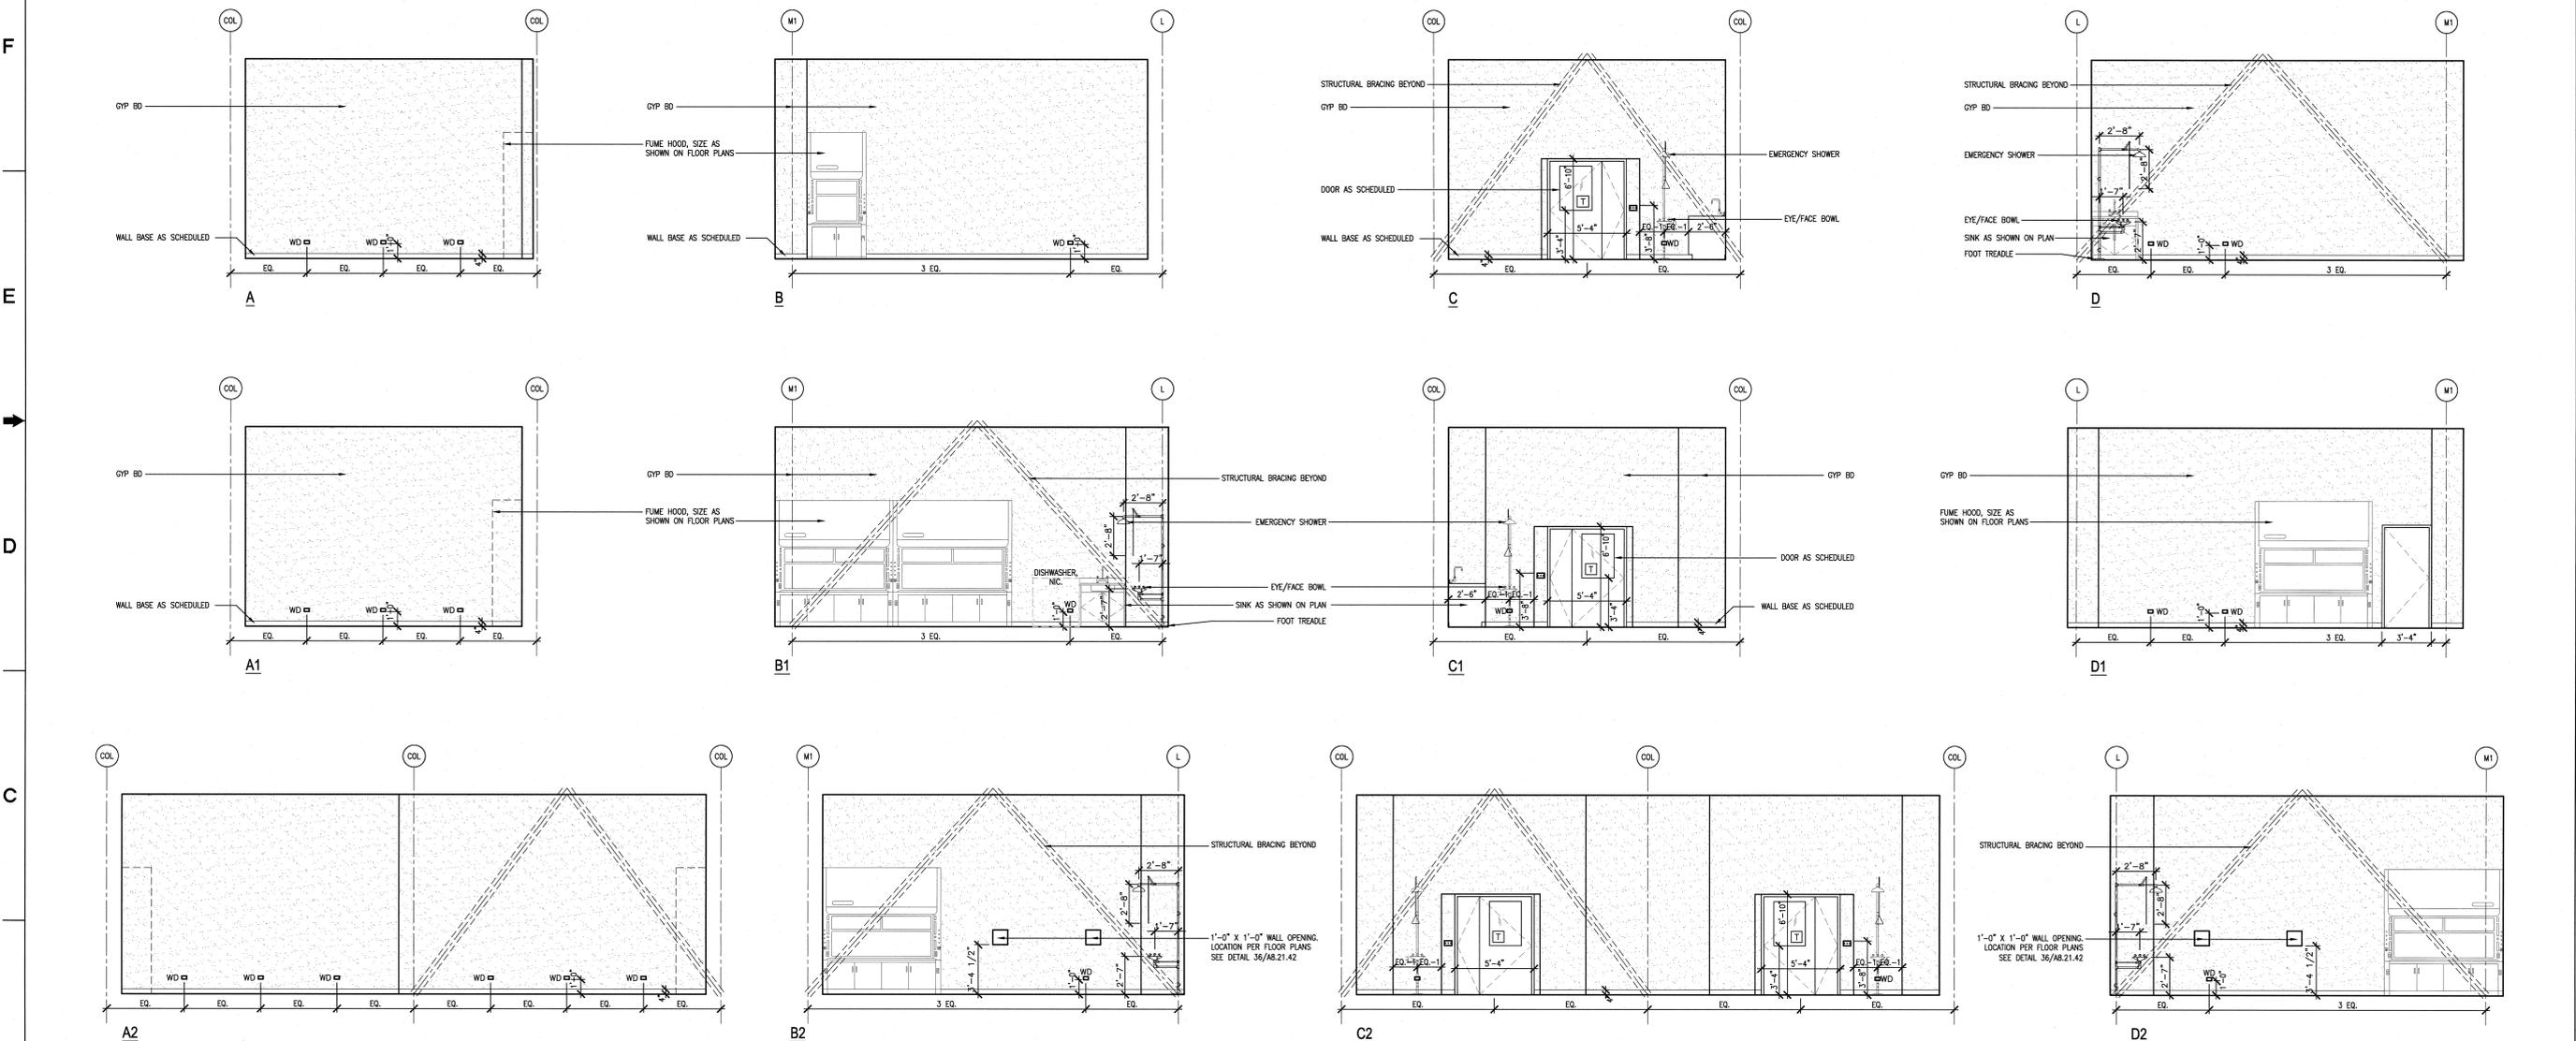

2 TYPICAL ELEVATIONS @ LABORATORIES  
AS.11.43 1/4"=1'-0"

AE004-8

ORNL DRAWING NUMBER:  
Knight/Jacobs Joint Venture  
701 Scoboro Road, MS 8253  
Oak Ridge, TN 37830  
865-241-8433  
fax 865-241-3400

**m+w zander**  
M+W Zander U.S. Operations, Inc.  
549 West Randolph Street  
Chicago, IL 60661  
Telephone: (312) 577-3200  
Fax: (312) 577-3625

ORNL National Laboratory  
managed for the DEPARTMENT OF ENERGY under  
U.S. GOVERNMENT CONTRACT DE-AC05-00OR22725  
"AS-BUILT" U.S. - Oak Ridge, Tennessee

PROJECT NAME:  
**CENTER FOR NANOPHASE MATERIALS SCIENCES  
INTERIOR ELEVATIONS  
ELEVATOR LOBBY & CORRIDORS  
LABORATORIES**

1	48	49	50	PLANT	BLDG	FL	SH.	OF	TYPE	CLASS
3	A	X	X	8	8610		1	1	P	U
5	1	52	53	A/E DRAWING NUMBER:						
NC	NA									AE.11.43

REV	DATE	DESCRIPTION	DSN	CHK	DEPT	DATE	PE	DATE	PA	DATE	REO	DATE	UTB	DATE	RPE	RPE NO	DATE	ST	CV	EC	EE	EM	IE	M	PD	SE	AR
0		CERTIFIED FOR CONSTRUCTION-12/9/02	CF	ED											RLB	102104	12/9/02	RZ	AW	BNW	AK	IM	DM		BNW		TW
1	12/03/02																										

THIS DOCUMENT CONTROLLED BY  
CHANGE CONTROL SYSTEM  
ENGINEERING PROCEDURE

NUMBER OF SECTION OR DETAIL  
DRAWING OF WHICH SECTION OR DETAIL IS SHOWN OR TAKEN  
SECTION AND DETAIL KEY

NO REPRESENTATION OR WARRANTY, EXPRESSED OR IMPLIED, IS MADE AS TO THE ACCURACY, COMPLETENESS OR USEFULNESS OF THE INFORMATION OR STATEMENTS CONTAINED IN THESE DRAWINGS, OR THAT THE USE OR DISCLOSURE OF ANY INFORMATION, APPARATUS, METHOD, OR PROCESS DISCLOSED IN THESE DRAWINGS MAY NOT INFRINGE PRIVATE RIGHTS OF OTHERS. NO LIABILITY IS ASSUMED WITH RESPECT TO THE USE OF, OR FOR DAMAGES RESULTING FROM THE USE OF ANY INFORMATION, APPARATUS, METHOD, OR PROCESS DISCLOSED IN THESE DRAWINGS. DRAWINGS ARE AVAILABLE FOR INFORMATION TO BIDDERS AND NOT TO BE USED FOR OTHER PURPOSES AND ARE TO BE RETURNED UPON REQUEST OF THE FORWARDING CONTRACTOR.

AutoCAD